

DECLARATORY
Improvement Res. No. 1240-1969
~~XXXXXXXXXX~~

For the Vacation of the alley between Culbertson Street and Beadell Street from the west property line of Vacated Berghoff Street to the west line of Lots 48 and 49, Commercial Addition.

Resolution Adopted: May 19, 1969

Confirmed:

Bids Received:

Contract Awarded:

Contract and Bond:

Contractor:

Reported Completed:

Assessment Roll Confirmed:

JUN 26 1969

B.O.67-69

Rolling Mill Redevelopment Project

DECLARATORY RESOLUTION NO. 1240-1969

For the Vacation of the alley between Culbertson Street and Beadell Street from the west property line of Vacated Berghoff Street to the west line of Lots 48 and 49, Commercial Addition.

PLANS ORDERED:

ADOPTED: May 19, 1969

ADVERTISE NOTICE TO PROPERTY OWNERS: WAIVED

HEARING ON CONFIRMATION:

CONFIRMED: May 19, 1969
May 19, 1969

ASSESSMENT ROLL ORDERED:

ASSESSMENT ROLL APPROVED: June 3, 1969

HEARING ON CONFIRMATION

OF ASSESSMENT ROLL: Thurs., June 26, 1969, 3:30 p. m.

NOTICE SERVED: June 13, 1969

ASSESSMENT ROLL CONFIRMED: June 26, 1969

For the Vacation ~~Opening~~ ~~Condemnation of right of way for utility purposes~~ of the alley between Culbertson Street and Beadell Street from the west property line of Vacated Berghoff Street to the west line of Lots 48 and 49, Commercial Addition.

Resolved by the Board of Public Works of the City of Fort Wayne, Indiana, that it is desired and deemed necessary to vacate the alley between Culbertson Street and Beadell Street from the west property line of Vacated Berghoff Street to the west line of Lots 48 and 49, Commercial Addition.

All as shown by a plan of such proposed Vacation ~~Opening~~ ~~Condemnation of right of way for utility purposes~~ as above described, now on file in the Office of the Department of Public Works of the City of Fort Wayne, Indiana

The cost of said Vacation ~~Opening~~ ~~Condemnation of right of way for utility purposes~~ shall be assessed against the property beneficially affected thereby.

The property which may be injuriously or beneficially affected by such Vacation ~~Opening~~ ~~Condemnation of right of way for utility purposes~~ is described as follows: Lots 42 to 57 inclusive, all in Commercial Addition. Said addition is inclusive to the City of Fort Wayne, Indiana.

All according to the method and manner provided for in an act of the General Assembly of the State of Indiana, entitled "An Act Concerning Municipal Corporations", as approved March 6, 1905 and the provisions of all acts amendatory thereto and supplemental thereof, including the right to bond assessments as in said law ordered.

Assessments if deferred are to be paid in ten equal installments with interest at the rate of five (5) % per annum. Under no circumstances shall the City of Fort Wayne, Indiana be or be held responsible for any sum or sums due from the said property owner or owners, or for the payment of any bond or bonds, except for such moneys as shall have been actually received by the City from the assessments for such property damages as said City is by said above entitled act required to pay. All proceedings had in the making of said improvement, assessment of property, collection of assessments and issuance of bonds therefor, shall be as provided for in said above entitled act and all amendments thereto and supplements thereof.

A portion ~~The vacation~~ of the above described alley shall be subject to an easement for the use of the City of Fort Wayne, Indiana, ~~and other public utilities~~ for the construction and maintenance of sewers, ~~water mains, gas mains, electric pole lines and conduits, telephone and telegraph pole lines and conduits.~~

All Streets, lots and lands affected by the above described vacation are situated in the northeast quarter of Section Nine, Township 30 north, Range 12 east and lie wholly within the corporate limits of the City of Fort Wayne, Indiana.

ADOPTED THIS 19 DAY OF May 1969.

Attest:

Secretary Board of Public Works.

Robert W. Walman
Board of Public Works.

OFFICE OF
BOARD OF PUBLIC WORKS



FORT WAYNE 2, INDIANA

53-170-9

B.O. 67-69

Date May 19, 1969

To City Engineer

Subject Dec. 1240-1969 alley between Culbertson & Beadell

Prepare Assessment Roll of Benefits \$1.00 and Damages \$1.00.

Fred S. Ehrman
Robert W. Dahman
George F. Gable
BOARD OF PUBLIC WORKS

ic
encl. Res. & P. O. List

NOTED

☐ F.S.E.
☒ R.W.D.
☐ G.F.G.

Signed _____

Date _____

Reply:

May 26, 1969

Assessment roll of Benefits and Damages completed and attached.


Donald E. Bodeker
Donald E. Bodeker
Office Manager

DEB:lc
attache.



Signed _____

SENDER: REMOVE & KEEP 3RD COPY - RECEIVER: ANSWER & KEEP 2ND COPY - RETURN 1ST COPY

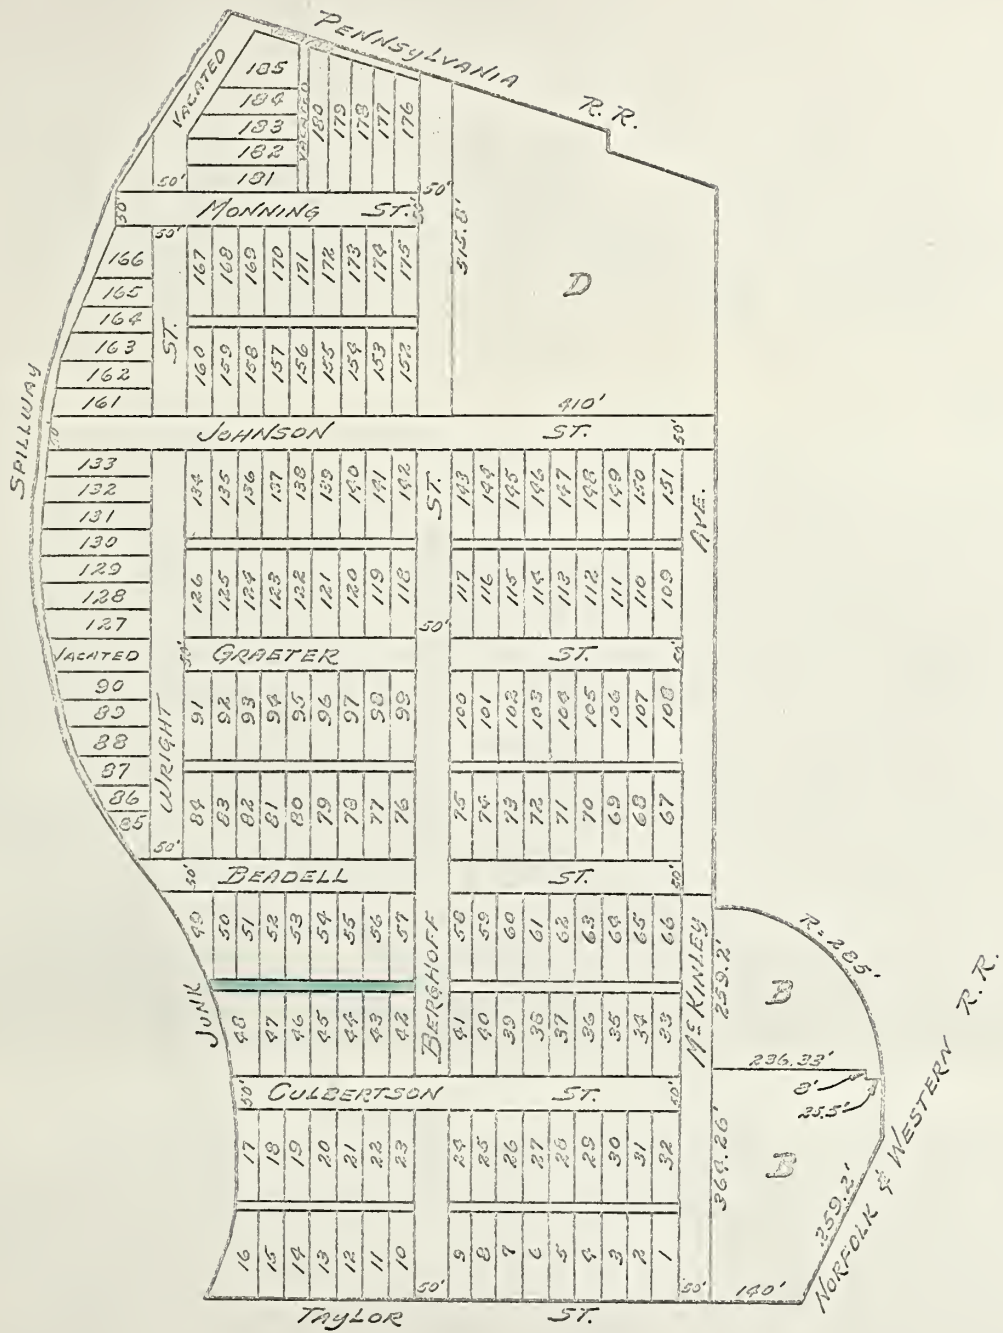

Rolling Mill Map
Commercial Addition




1240



SCALE: 1" = 300'

BRIGHT

STREET

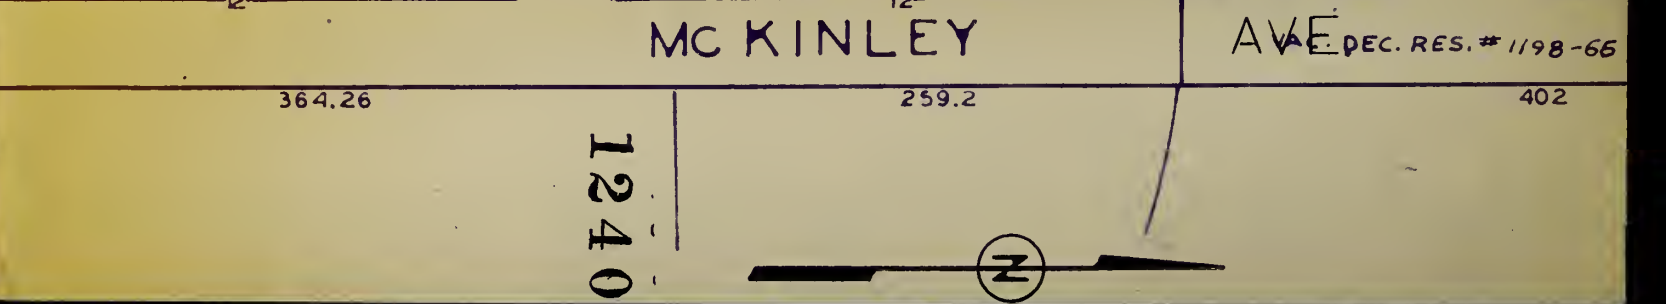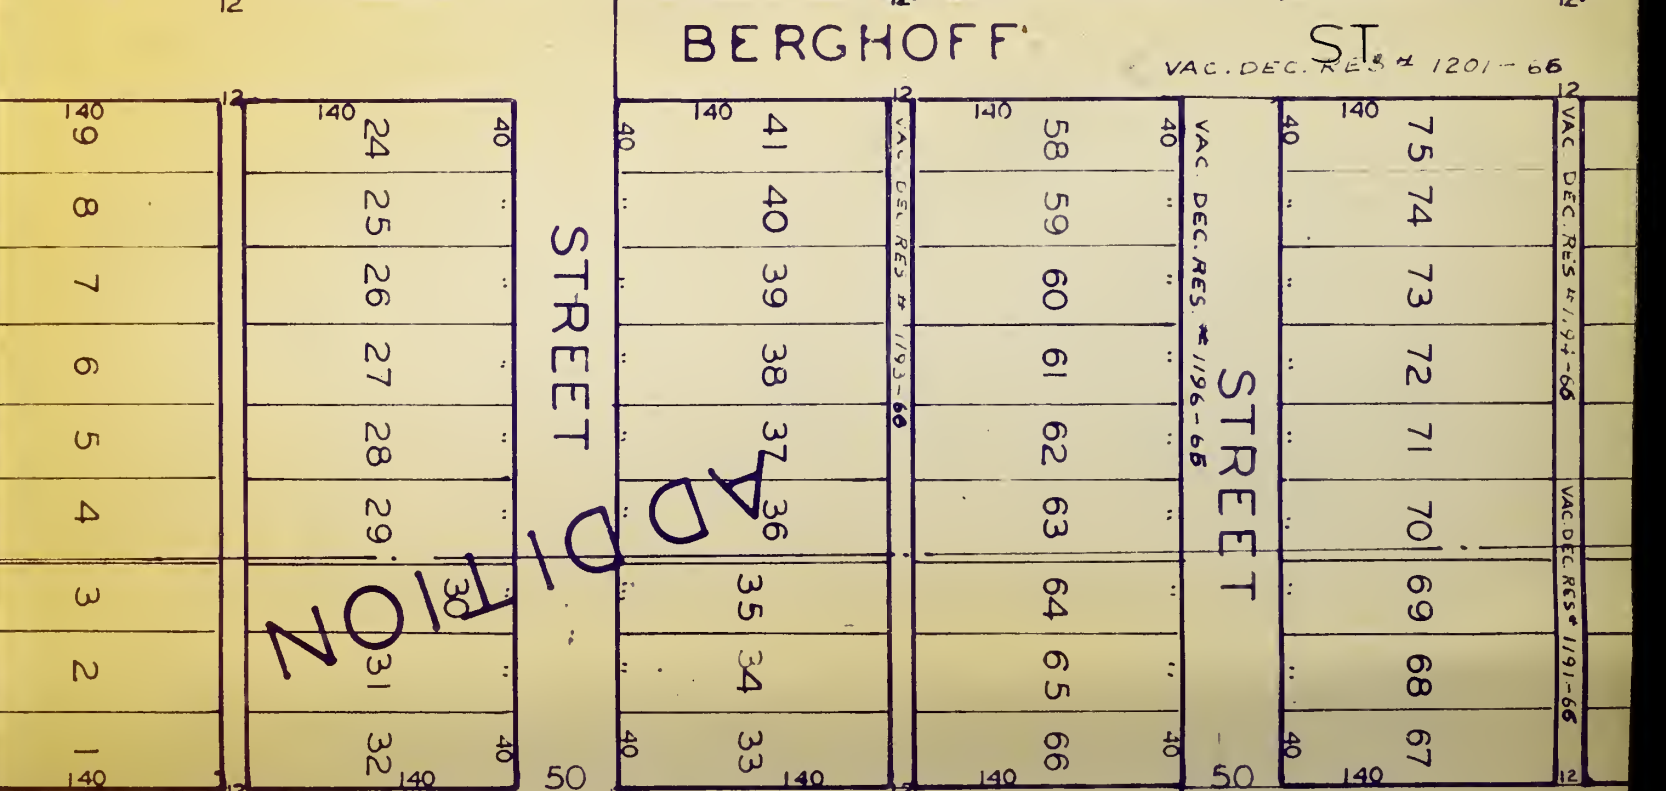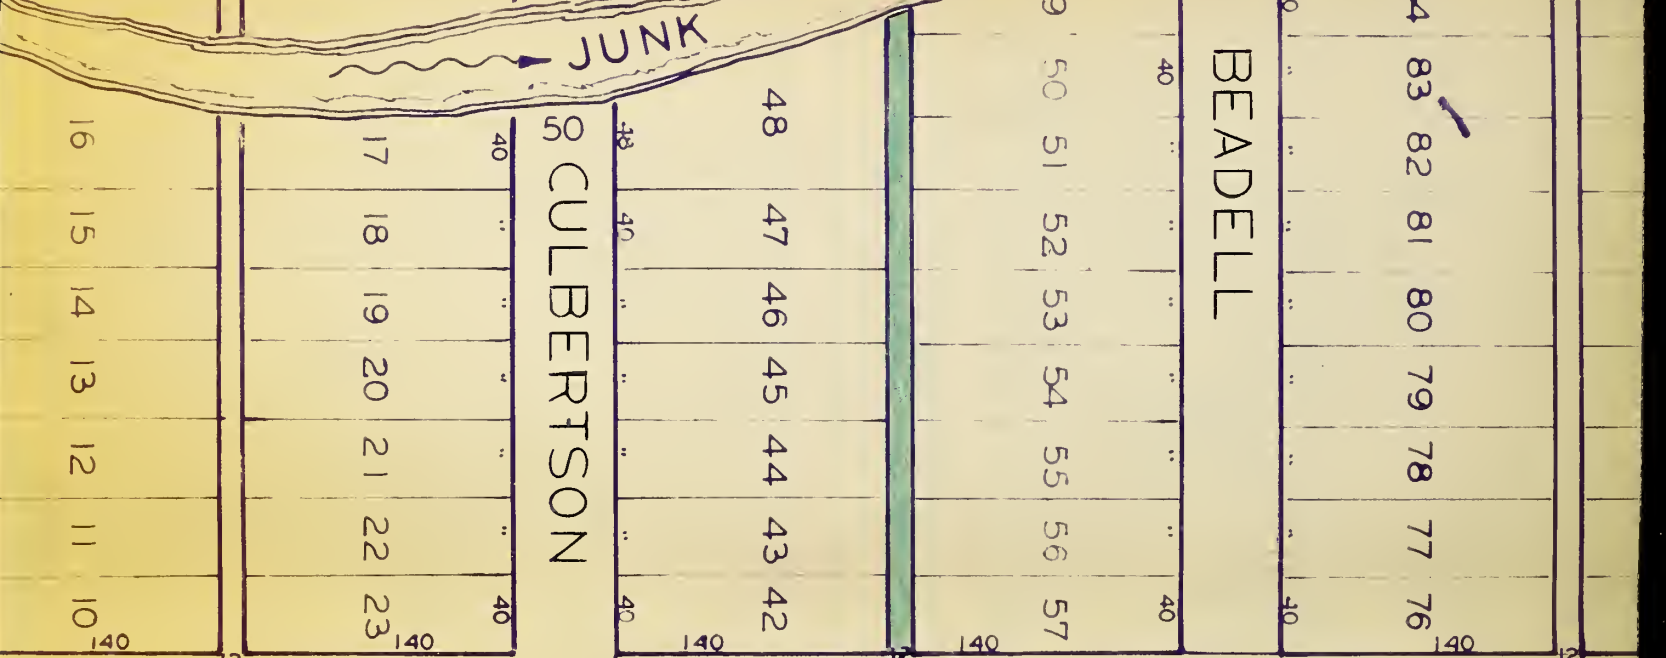

WAIVER

The undersigned City of Fort Wayne, Department of Redevelopment, which except for the property owned by Joslyn Mfg. and Supply Co., is the owner of all of the property which may be injuriously or beneficially affected by the proposed vacation of an alley described as follows, to wit:

The alley between Culbertson Street and Beadell Street from the west property line of Vacated Berghoff Street to the west line of Lots 48 and 49, Commercial Addition.


which proposed vacation is set out in Declaratory Resolution No. 1240 - 1969 of the Board of Public Works of the City of Fort Wayne, Indiana, does hereby waive any and all rights it may have to receive notice of such resolution either by publication or otherwise, and does waive its right to a hearing on said resolution and its right to file or present in any any remonstrance against the action taken by said Board under said resolution; and it does agree that said Board may take such final action as it may deem appropriate on said resolution, either confirming, modifying or rescinding said resolution, and that such action so taken shall be final and conclusive upon said Department of Redevelopment.

Dated this 17th day of April, 1969.

CITY OF FORT WAYNE

DEPARTMENT OF REDEVELOPMENT

BY:

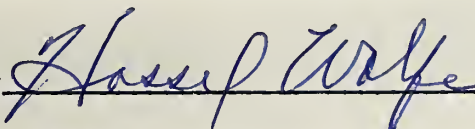

Hassel Wolfe, Executive Director

1240

WAIVER

The undersigned Corporation, which, except for the property owned by the City of Fort Wayne, Department of Redevelopment, is the owner of all of the property which may be injuriously or beneficially affected by the proposed vacation of an alley described as follows, to wit:

The alley between Culbertson Street and Beadell Street from the west property line of Vacated Berghoff Street to the west line of Lots 48 and 49, Commercial Addition.

which proposed vacation is set out in Declaratory Resolution No. 1240 - 1969 of the Board of Public Works of the City of Fort Wayne, Indiana, does hereby waive any and all rights it may have to receive notice of such resolution either by publication or otherwise, and does waive its right to a hearing on said resolution and its right to file or present in any way any remonstrance against the action taken by said Board under said resolution; and it does agree that said Board may take such final action as it may deem appropriate on said resolution, either confirming, modifying or rescinding said resolution, and that such action so taken shall be final and conclusive upon said Corporation.

Dated this 12th day of April, 1969.

JOSLYN MFG. AND SUPPLY CO.

BY: R. J. Rahn

ITS: Works Mgr.

1240

DECLARATORY

Improvement Resolution No. 1240

-1969

For THE VACATION OF THE ALLEY BETWEEN CULBERTSON STREET AND

BEADELL STREET FROM THE WEST PROPERTY LINE OF VACATED BERGHOFF STREET TO THE WEST LINE OF LOTS 48 AND 49, COMMERCIAL ADDITION.

	OWNER'S NAME	ADDRESS	NUMBER OF			DESCRIPTION
			LOT	BLOCK	O.L.	
1	JOSLYN MFG. & Supply Co.	1701 MCKINLEY AVE	49			COMMERCIAL ADD.
2	" " " " "	" "	50			" "
3	" " " " "	" "	51			" "
4	" " " " "	" "	52			" "
5	" " " " "	" "	53			" "
6	" " " " "	" "	54			" "
7	" " " " "	" "	55			" "
8	" " " " "	" "	56			" "
9	" " " " "	" "	57			" "
10	" " " " "	" "	48			" "
11	" " " " "	" "	47			" "
12	CITY OF FORT WAYNE	70 REDEVELOPMENT COMM. 425 S. CALHOUN ST.	46			" "
13	" " " " "	" "	45			" "
14	" " " " "	" "	44			" "
15	" " " " "	" "	43			" "
16	" " " " "	" "	42			" "
17						
18						
		TOTAL				

1240